



WATER AND WASTEWATER SERVICE INSTALLATION REPORT

Address: _____

Permit Number: _____

Subdivision: _____

Lot No.: _____ Block No.: _____

Installation Date: _____

Installation Date: _____

Water and Wastewater Services Sketch

Wastewater Profile Sketch

Sketch Criteria: Include North Arrow, lot lines, pipe lengths and material types, depths, couplings, fittings, clean-outs, meter pit, foundation, pipe slopes, ground level.

Installer Certificate: (by signing you are certifying that the sketch is drawn correctly)

Company Name: _____ Installer name: _____

Address: _____ Installer Signature: _____

City: _____ State: _____ Zip: _____ Phone No.: _____

Builder Certificate: (by signing you are approving the water and sewer services as installed)

Company Name: _____ Superintendent name: _____

Address: _____ Superintendent Signature: _____

City: _____ State: _____ Zip: _____ Phone No.: _____




* SAMPLE *

Water & Wastewater Service Installation Report


Once complete, please submit this form to the Building Division at 500 E 3rd Street, Suite 110 or email to plans@cityofloveland.org. This form is required prior to Certificate of Occupancy, but may be submitted at any time during construction. If you have any questions on this form contact (970) 962-3750.

Address: 123 Main Street Building Permit #: 13-00001
Subdivision: Residential 2nd Sub Installation Date: 10/01/2013
Lot #: 1 Block: 2

Water and Wastewater Service Sketch

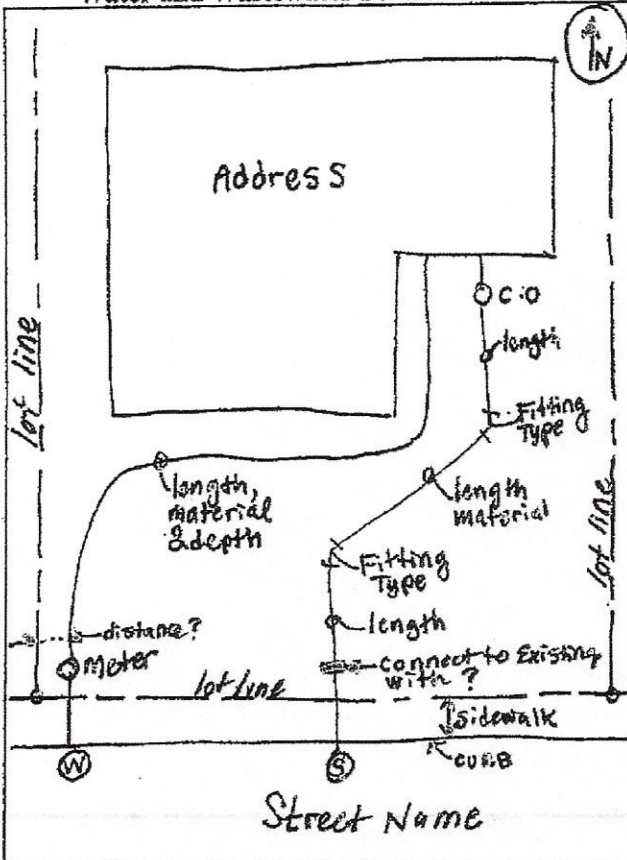

Wastewater Profile Sketch

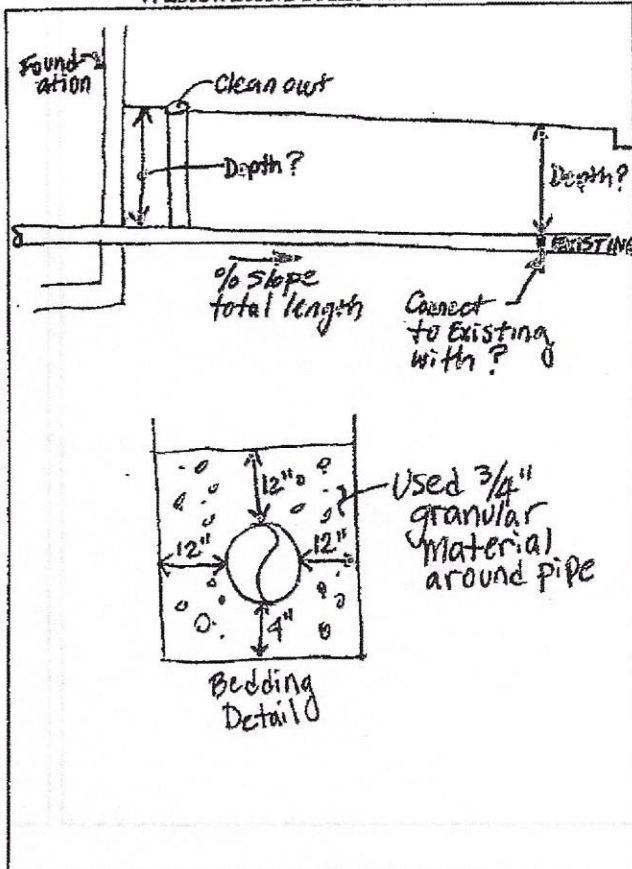

Sketch Criteria: Show North Arrow, lot lines, piping lengths, piping material types, depths, couplings, fittings, clean-outs, curb stop box or meter pit referenced from two locations, sidewalk with "W" and "S" each location, foundation, ground level, piping slope.

Installer Certification: (By signing, you are certifying that the sketch is drawn correctly.)

Company Name: Service Sub Contractor Installer name: Dan Pipe
Address: 456 Pipe Drive Installer Signature: [Signature]
City: Denver State: CO Zip: _____ Phone #: (303) 999-9999

Builder Certification: (By signing, you are certifying that the Installer has installed the water and sewer services as sketched.)

Company Name: Building General Superintendent name: Bill House
Address: 789 New Home Street Superintendent Signature: [Signature]
City: Loveland State: CO Zip: 80538 Phone #: (970) 999-9999